

THE DRAWING AND DESIGN HEREIN SHALL NOT BE REPRODUCED, COPIED OR DISCLOSED TO OTHERS FOR PROCUREMENT BY OTHER PURPOSE (EXCEPT AS OTHERWISE AUTHORIZED BY CONTRACT) WITHOUT WRITTEN PERMISSION OF SIEMENS BUILDING TECHNOLOGIES, INC.. THE SAFETY OF LIFE AND LIMB HEREON THIS DRAWING SHALL BEAR THIS NOTICE.


REVISIONS

No.	Revision	By	Date	Appr.
1	BULLETIN 5	JPM	9/20/10	KW
2	RESPONSE TO HYT BULLETIN 5 REVIEW COMMENTS	JPM	10/19/10	KW
3	REVISED PER LBNL FIRE MARSHALS' COMMENTS	JPM	10/25/10	KW
4	AS-BUILT	JPM	9/20/12	KW

AS-BUILT

2-11 APPROVAL STAMP

OWNER OF CONTROL DOCUMENTS


HYT Corporation
Fire Protection Engineers and Consultants
3498 Clayton Road - Suite 101 Concord, California 94519
Phone: (925) 681-2731 FAX: (925) 681-2733

INSTALLATION CONTRACTORS NAME & ADDRESS:

**W. BRADLEY
ELECTRIC, INC.**

90 Hill Road,
Novato, CA 94945

Tel (415) 898-1400 Fax (415) 898-5991

PRODUCT MANUFACTURER:

Siemens Industry, Inc.
Fire Safety Division

25821 Industrial Boulevard, Suite 300
Hayward, California 94545-2991
Tel (510) 783-6000 Fax (510) 293-2100
California State C10 License No. 758796
U.L. Certificate ID No. 324787-001

JOB NAME & LOCATION (STREET ADDRESS):

 **UNIVERSITY OF CALIFORNIA
BERKELEY BERKELEY NATIONAL LABORATORY**
FACILITIES DIVISION

**BUILDING 74
FIRE ALARM**

**LBNL SEISMIC
PHASE 2**

One Cyclotron Road,
Berkeley, California 94720

HEET COORDINATE:

**FIRE ALARM PLAN -
FLOOR 3 (PROTECTOWIRE)**

INSTALLATION TYPE:

- ☐ NEW INSTALLATION
☐ DESIGN/BUILD
☐ PER CONTRACT DOCUMENT
☐ EXISTING BASE JOB # N/A
☐ OTHERS _____

SYSTEM SALES REP: Kevin Waxman

PROJECT MANAGER: Mark Millard

DRAWN BY: JPM

CHECKED BY: FA-11

SCALE: 1/8" = 1'-0"

DATE DRAWN: March 18, 2010 PLOT DATE: March 27, 2014

DRAWING NO.

6N74E336

SHEET


FA-11A

JOB NUMBER

44OP-069681


SHEET NOTES:

- 1 ALL FIRE ALARM EQUIPMENT AND PROTECTOWIRE ZONE BOXES SHALL BE PLACED IN A LOCATION SUCH THAT THEY ARE READILY ACCESSIBLE FOR MAINTENANCE AND TESTING. (TYPICAL TO ALL OPEN CEILING AREAS)
- 2 FASTENERS SHOULD TYPICALLY BE SPACED EVERY 5-10 FEET, OR AS MAY BE NECESSARY TO PREVENT THE WIRE FROM SAGGING WHICH PUTS UNDUE STRESS ON THE WIRE AT THE FASTENING POINTS.

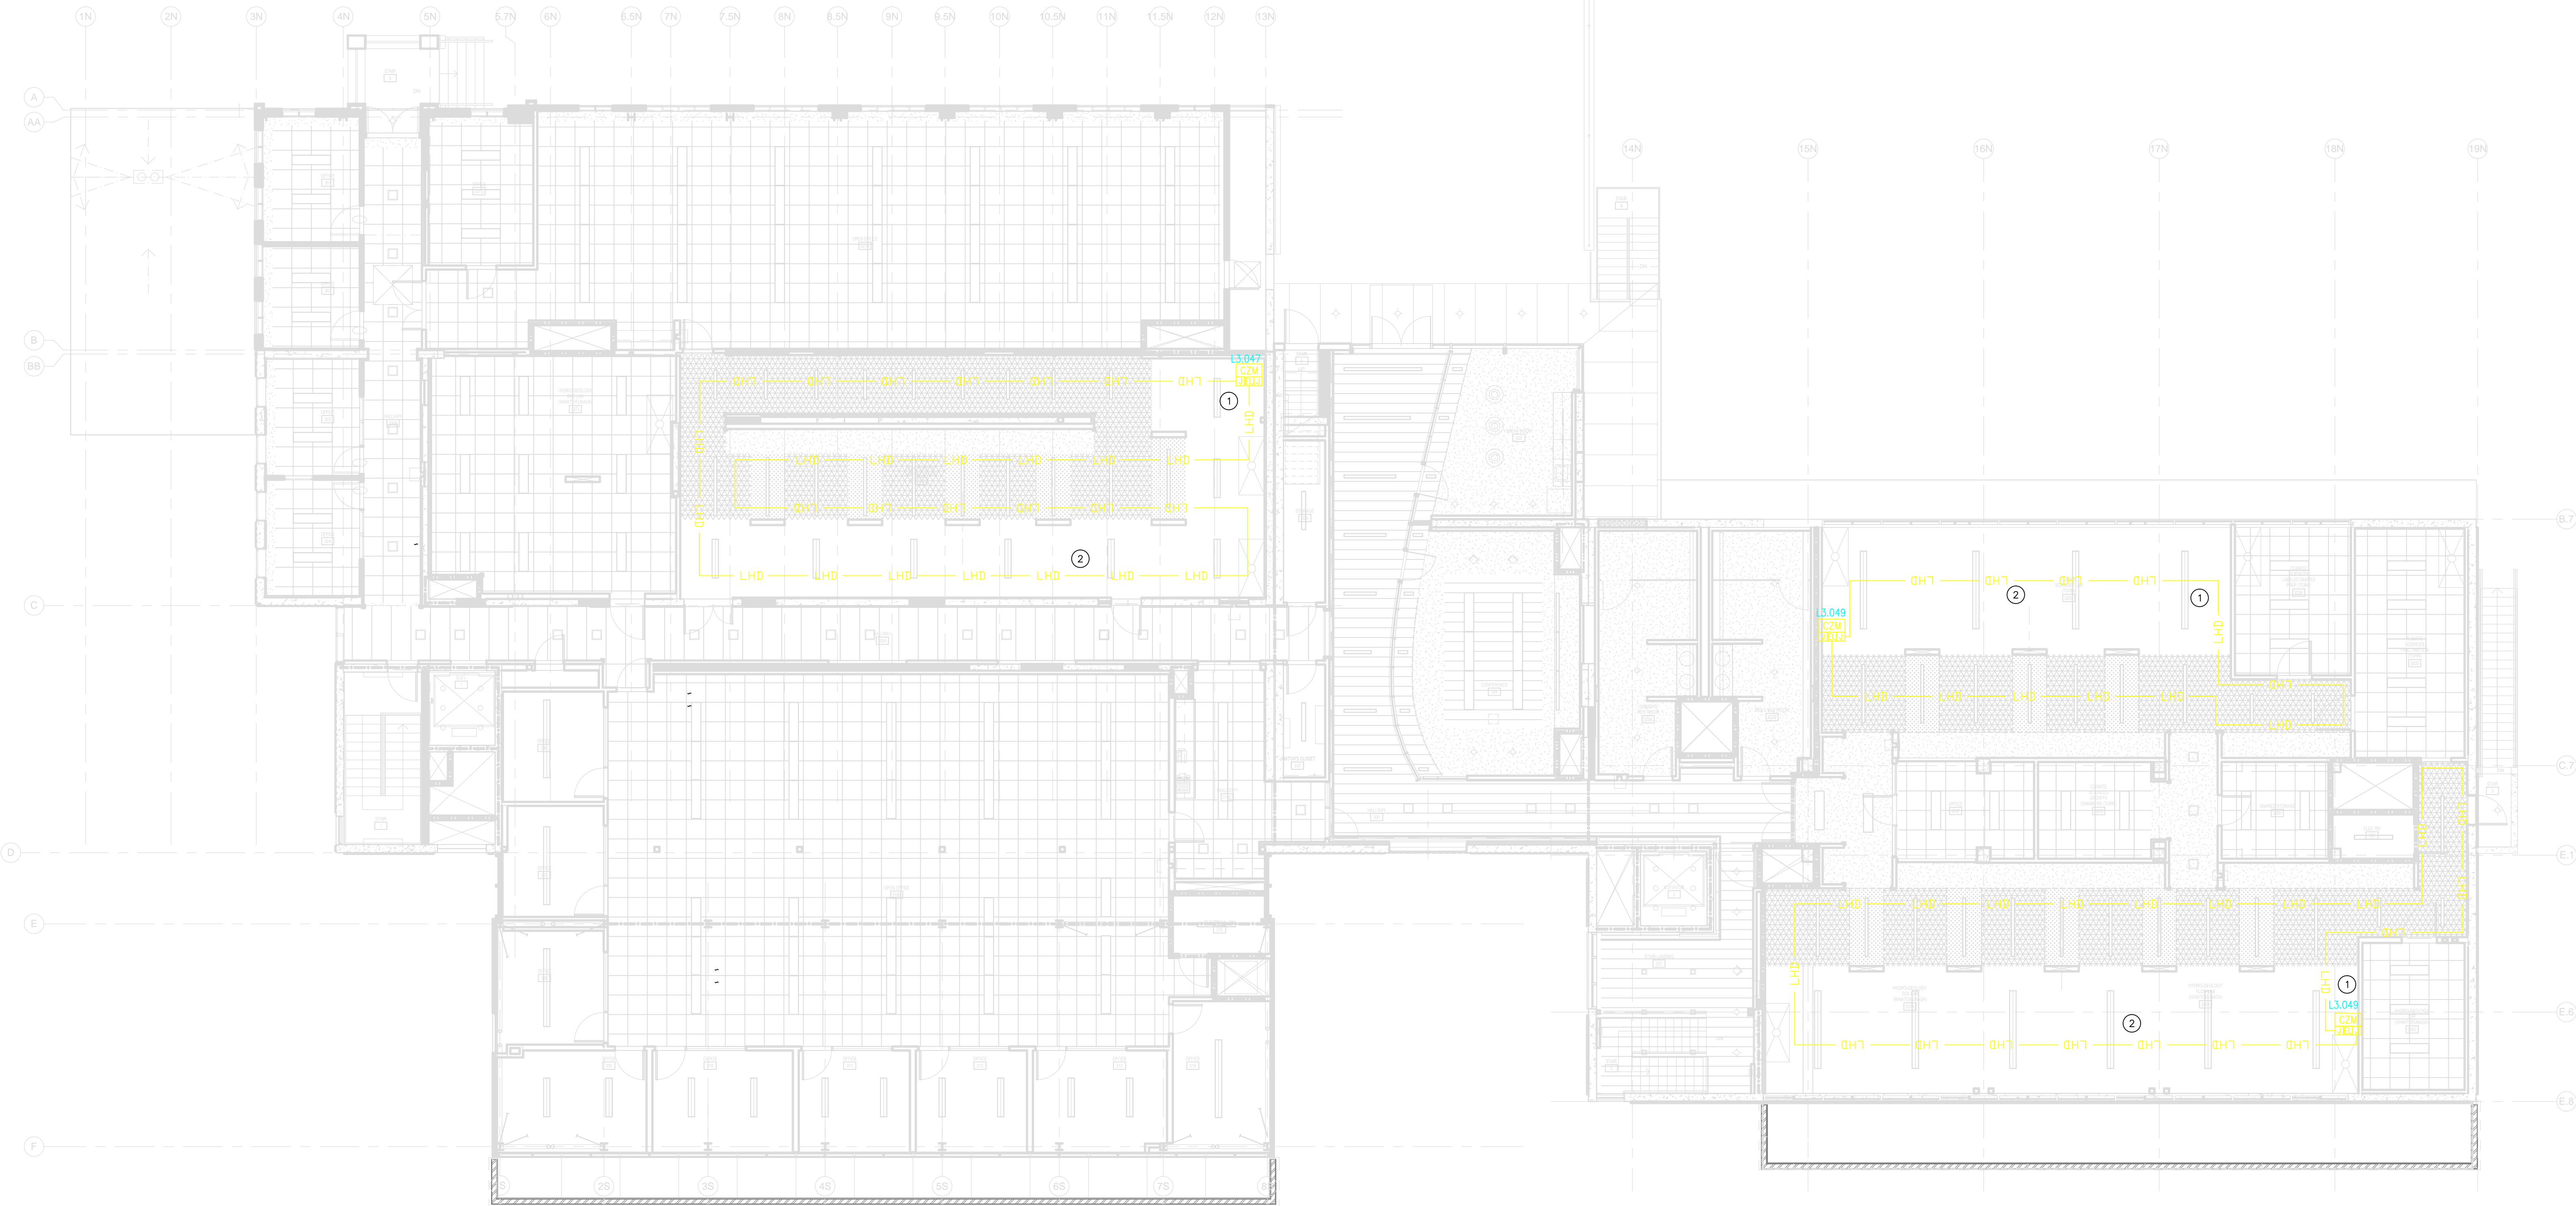

FIRE ALARM PLAN - FLOOR 3

SCALE: 1/8" = 1'-0"

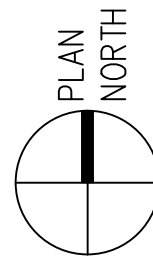

IF DRAWING IS SHAPED, PRINT 30" X 42" IT IS A REDUCED COPY